


| REVISION |                                        |         |         |             |
|----------|----------------------------------------|---------|---------|-------------|
| REV      | DESCRIPTION                            | DRAWN   | APPR    | DATE        |
| IR       | Initial Registration                   | G.Y.KIM | I.C.KIM | 2016.11.25. |
| 1        | [설번처리 No.201612-0028] 상대물 결함 텐션 약하게 변경 | G.Y.KIM | I.C.KIM | 2016.12.28. |
| 2        | 도금사양 변경 (Gold->Nickel) 영업 요청           | I.C.KIM |         | 2017.02.20. |

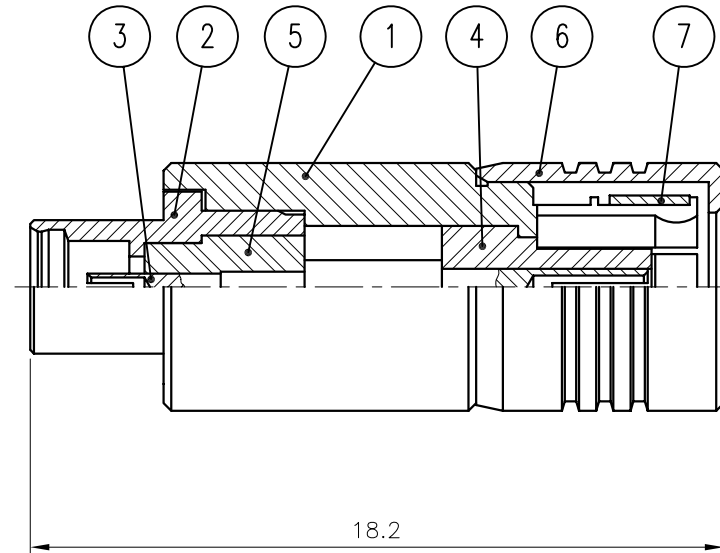

Electrical spec

1. Insertion Loss: 0.2dB @ DC~3Ghz

#### \*조립방법

1. ①번 BODY(A)에 ④번 TEFLON을 조립한다.
2. ②번 BODY(B)에 ⑤번 TEFLON을 조립한다.
3. ①번 BODY(A)에 ③번 PIN을 조립하고 ②번 BODY(B)를 억지끼움 한다.
4. ⑦번 SPRING RING을 조립한다.
5. ⑥번 CAP을 ①번 BODY(A)에 억지끼움 한다.

| 1 | 7   | SPRING RING  | 1    | BeCu<br>C17300     | Copper Plate                          | DSR00009-5/1<br><del>DSR00004-5/1</del> |
|---|-----|--------------|------|--------------------|---------------------------------------|-----------------------------------------|
| 2 | 6   | COUPLING CAP | 1    | MBsBD<br>C3604BD-F | Nickel Plate<br><del>Gold Plate</del> | DCU00021-5/3                            |
|   | 5   | INSULATOR    | 1    | TEFLON             |                                       | DIN02852-N/1                            |
|   | 4   | INSULATOR    | 1    | TEFLON             |                                       | DIN02851-N/1                            |
|   | 3   | CONTACT      | 1    | BeCu<br>C17300     | Gold Plate                            | DAC03264-5/1                            |
| 2 | 2   | BODY(B)      | 1    | MBsBD<br>C3604BD-F | Nickel Plate<br><del>Gold Plate</del> | DBD02161-5/2                            |
| 2 | 1   | BODY(A)      | 1    | MBsBD<br>C3604BD-F | Nickel Plate<br><del>Gold Plate</del> | DBD04257-5/2                            |
|   | NO. | DESCRIPTION  | Q'TY | MATERIAL           | PLATING                               | CODE                                    |

|           |         |                    |         |                                                                               |
|-----------|---------|--------------------|---------|-------------------------------------------------------------------------------|
| TOLERANCE | Decimal | DATE 2017. 02. 20. |         | <br>RF & MICROWAVE TECHNOLOGY<br>Tel : 82-32-347-8015<br>Fax : 82-32-347-8017 |
|           | Angle   | APPROVED BY        |         |                                                                               |
| MATERIAL  |         | CHECKED BY         |         | <b>KJ COMTECH CO.,LTD.</b><br>TITLE<br>MMCX50 (J) SMB50 (P) ST Adaptor        |
|           |         | DRAWN BY           | I.C.KIM |                                                                               |
| FINISH    |         | SCALE              | UNIT    | A4 DWG NO. AD00596-7/2<br>REVISION 2 SHEET 1 of 1                             |
|           |         | 5/1                | mm      |                                                                               |