
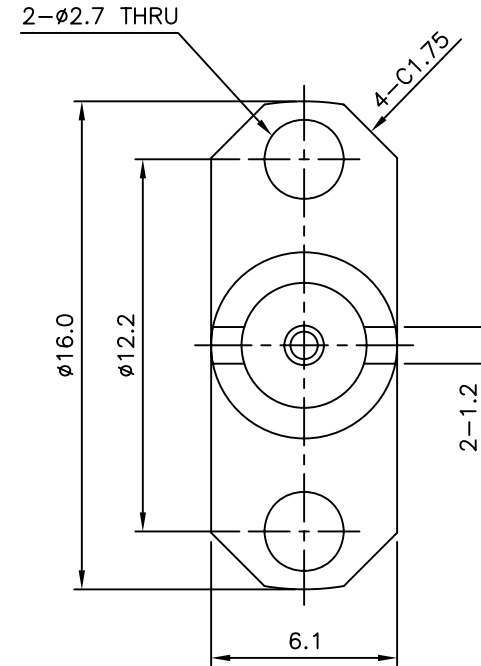


| REVISION |                                      |         |          |               |
|----------|--------------------------------------|---------|----------|---------------|
| REV      | DESCRIPTION                          | DRAWN   | APPR     | DATE          |
| IR       | Initial Registration                 |         |          | 2001. 02. 03. |
| 1        | [설번처리No.201111-0007] BODY 내부 낙시바늘 추가 | I.C.KIM | J.H.YOUN | 2011. 11. 29. |
| 2        | 절연체 공용화로 인한 코드 변경                    | S.Y.EUN | I.C.KIM  | 2020. 12. 23. |

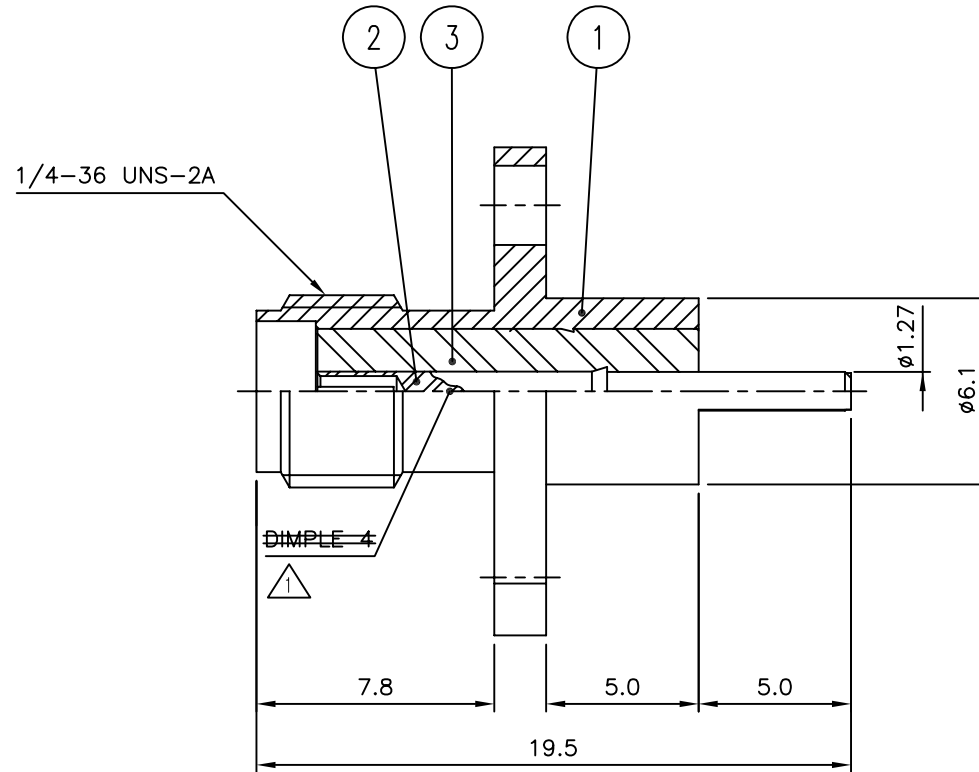

| 3   | INSULATOR   | 1    | TEFLON   |            | DIN02077-N/1<br><del>DIN00088-N/1</del> |
|-----|-------------|------|----------|------------|-----------------------------------------|
| 2   | CONTACT     | 1    | BeCu     | Gold Plate | DCT00203-5/1                            |
| 1   | BODY        | 1    | MBsBD    | Gold Plate | DBD00352-5/2<br><del>DBD00352-5/1</del> |
| NO. | DESCRIPTION | Q'TY | MATERIAL | PLATING    | CODE                                    |

|           |         |                    |         |                                                                               |
|-----------|---------|--------------------|---------|-------------------------------------------------------------------------------|
| TOLERANCE | Decimal | DATE 2020. 12. 23. |         | <br>RF & MICROWAVE TECHNOLOGY<br>Tel : 82-32-347-8015<br>Fax : 82-32-347-8017 |
|           | Angle   | APPROVED BY        | I.C.KIM |                                                                               |
| MATERIAL  |         | CHECKED BY         |         | <b>KJ COMTECH CO.,LTD.</b><br>TITLE<br>SMA50 SOLDER END JS-2H-2R              |
|           |         | DRAWN BY           | S.Y.EUN |                                                                               |
| FINISH    |         | SCALE              | 4/1     | A4 DWG NO. CN00163-7/2<br>REVISION 2 SHEET 1 of 1                             |
|           |         | UNIT               | mm      |                                                                               |