
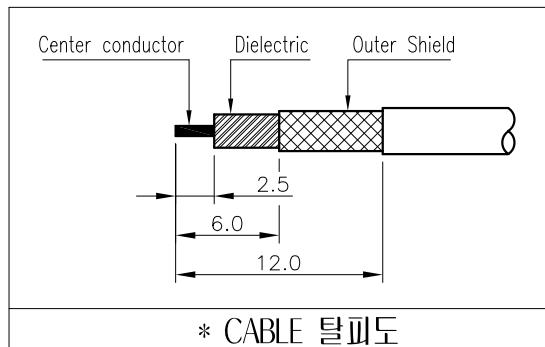


| REVISION |                                                      |         |         |             |
|----------|------------------------------------------------------|---------|---------|-------------|
| REV      | DESCRIPTION                                          | DRAWN   | APPR    | DATE        |
| 1A       | Initial Registration                                 | S.Y.EUN | I.C.KIM | 2018.03.05. |
| 1        | [실변처리No.201803-0008]<br>상대품 체결시 가스켓 돌출현상 없음 -바디,캡 수정 | S.Y.EUN | I.C.KIM | 2018.03.19. |

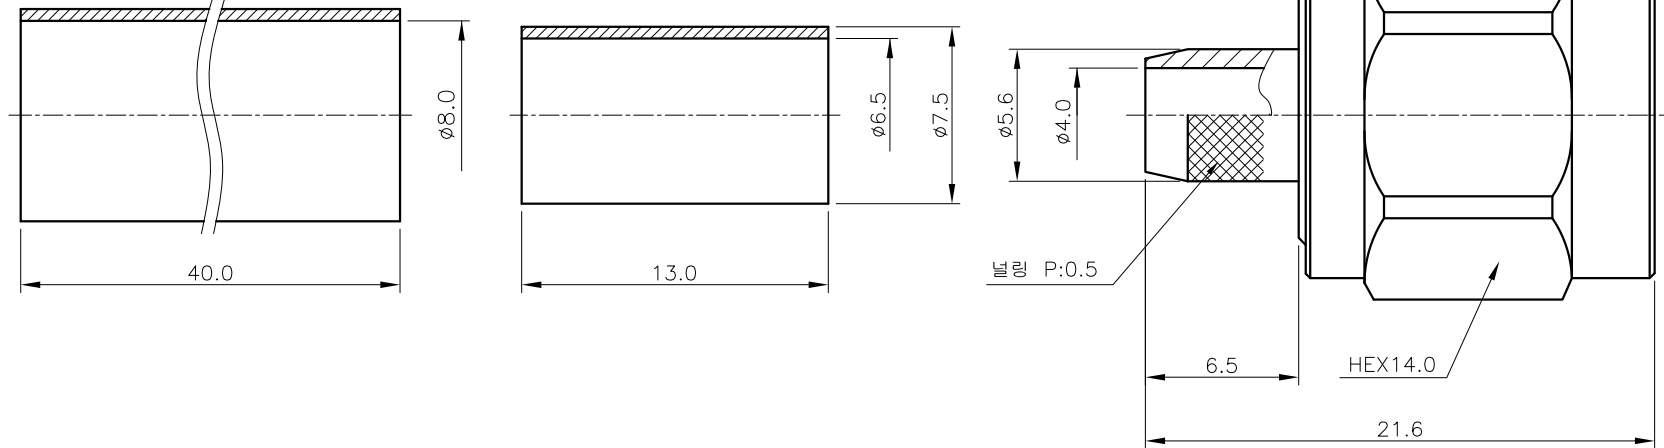

| 8   | BONDING TUBE | 1    | —                  | —            | ATU00351-N/1                            |
|-----|--------------|------|--------------------|--------------|-----------------------------------------|
| 7   | SPRING RING  | 1    | SUS                | Passivated   | DSR00024-5/1                            |
| 6   | CAP          | 1    | MBsBD<br>C3604BD-F | Nickel Plate | DCU00135-5/6<br><del>DCU00135-5/1</del> |
| 5   | INSULATOR    | 1    | TEFLON             |              | DIN02428-N/1                            |
| 4   | GASKET       | 1    | SILICONE RUB       |              | DGK00008-N/1                            |
| 3   | FERRULE      | 1    | MBsBD<br>C3604BD-F | Nickel Plate | DFE00062-5/2                            |
| 2   | CONTACT      | 1    | MBsBD<br>C3604BD-F | Gold Plate   | DCT00580-5/1                            |
| 1   | BODY         | 1    | SUS                | Passivated   | DBD03945-5/4<br><del>DBD03945-5/2</del> |
| NO. | DESCRIPTION  | Q'TY | MATERIAL           | PLATING      | CODE                                    |

|               |                 |                        |            |                                                                                       |                                                                                                                                                                                          |                        |
|---------------|-----------------|------------------------|------------|---------------------------------------------------------------------------------------|------------------------------------------------------------------------------------------------------------------------------------------------------------------------------------------|------------------------|
| TOLERANCE     | Decimal<br>±0.2 | DATE<br>2018. 03. 19.  |            |                                                                                       | <div><br/>RF &amp; MICROWAVE<br/>TECHNOLOGY<br/>Tel : 82-32-347-8015<br/>Fax : 82-32-347-8017</div> |                        |
|               | Angle<br>±1°    | APPROVED BY<br>I.C.KIM |            |                                                                                       |                                                                                                                                                                                          |                        |
| MATERIAL<br>— |                 | CHECKED BY             |            | TITLE<br>TNC50 CABLE PS LMR240                                                        |                                                                                                                                                                                          |                        |
|               |                 | DRAWN BY<br>S.Y.EUN    |            |                                                                                       |                                                                                                                                                                                          |                        |
| FINISH<br>—   |                 | SCALE<br>3/1           | UNIT<br>mm |  | A4                                                                                                                                                                                       | DWG NO.<br>CN02192-7/4 |
|               |                 |                        |            |                                                                                       |                                                                                                                                                                                          | REVISION<br>1          |