

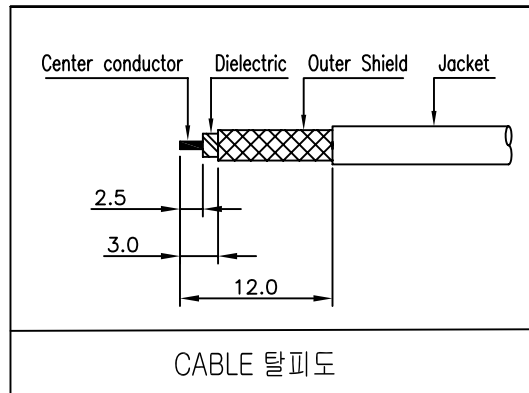


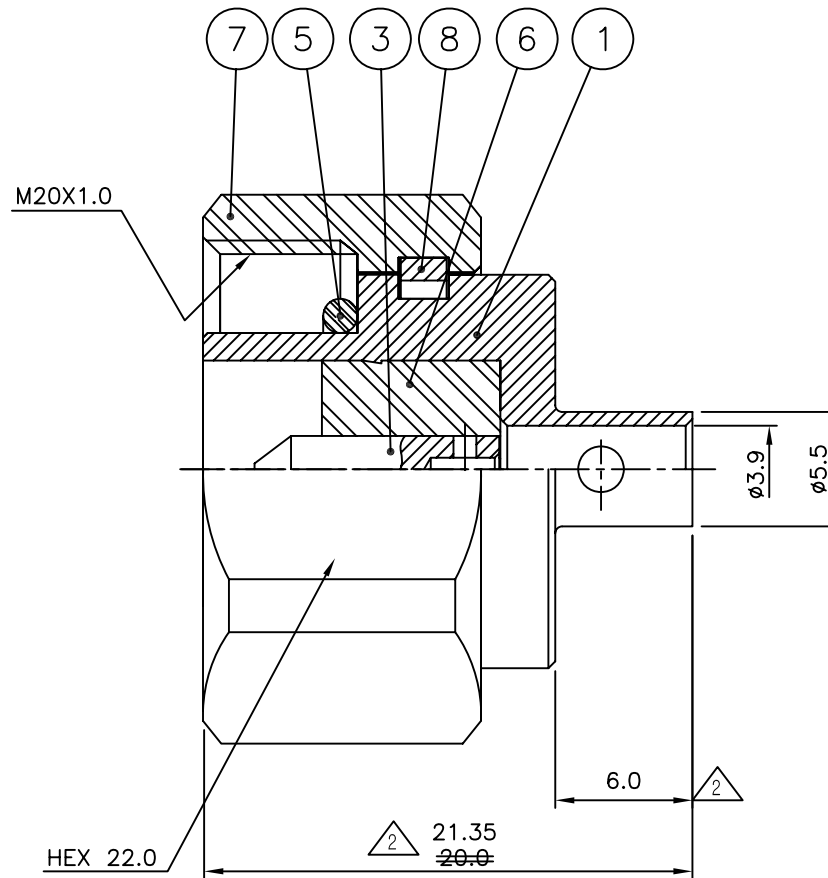

## REVISION

| REV | DESCRIPTION                                              | DRAWN   | APPR    | DATE        |
|-----|----------------------------------------------------------|---------|---------|-------------|
| IR  | Initial Registration                                     | H.J.LEE | I.C.KIM | 2016.01.18. |
| 1   | CAP 빠짐 현상으로 인한 CAP, BODY 치수 수정 및 CODE 변경                 | H.J.LEE | I.C.KIM | 2016.02.19. |
| 2   | [설번No.201707-0013] 납땜성 향상으로 인한 BODY 변경, 납땜Hole 추가, 패를 변경 | S.Y.EUN | I.C.KIM | 2017.07.21. |

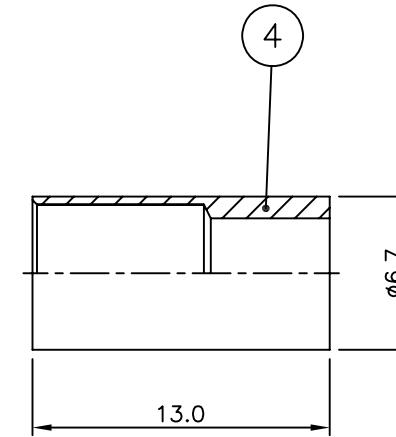

주 기

1. CAP 조립전 가시미 작업 진행

| 8            | SPRING RING     | 1            | PBR                            | Nickel Plate          | DSR00020-5/1                            |
|--------------|-----------------|--------------|--------------------------------|-----------------------|-----------------------------------------|
| 7            | COUPLING CAP    | 1            | MBsBD<br>C3604BD-F             | SUCO Plate            | DCU02257-5/6                            |
| 6            | INSULATOR       | 1            | TEFLON                         |                       | DIN02687-N/1                            |
| 5            | GASKET          | 1            | SILICONE RUB                   |                       | DGK00121-N/1                            |
| 4            | FERRULE         | 1            | MBsBD<br>C3604BD-F             | Nickel Plate          | DFE00205-5/1<br><del>DFE00183-5/1</del> |
| 3            | CONTACT         | 1            | MBsBD<br>C3604BD-F             | Silver Plate<br>(5μm) | DCT03592-5/2                            |
| <del>2</del> | <del>BODY</del> | <del>1</del> | <del>MBsBD<br/>C3604BD-F</del> | <del>SUCO Plate</del> | <del>DBD03073-5/2</del>                 |
| 1            | BODY            | 1            | MBsBD<br>C3604BD-F             | SUCO Plate            | DBD04068-5/4<br><del>DBD04068-5/3</del> |
| NO.          | DESCRIPTION     | Q'TY         | MATERIAL                       | PLATING               | CODE                                    |

|            |         |                    |         |                                                                                  |
|------------|---------|--------------------|---------|----------------------------------------------------------------------------------|
| TOLERANCE  | Decimal | DATE 2017. 07. 21. |         | <br>RF & MICROWAVE<br>TECHNOLOGY<br>Tel : 82-32-347-8015<br>Fax : 82-32-347-8017 |
|            | Angle   | APPROVED BY        | I.C.KIM |                                                                                  |
| MATERIAL   |         | CHECKED BY         |         | TITLE<br>4.1/9.5 DIN50 CABLE PS 141FJ                                            |
|            |         | DRAWN BY           | S.Y.EUN |                                                                                  |
| FINISH     |         | SCALE              | UNIT    | DWG NO. CN03523-7/3                                                              |
|            |         | 3/1                | mm      |                                                                                  |
|            |         |                    |         | A4                                                                               |
| REVISION 2 |         |                    |         | SHEET 1 of 1                                                                     |