


REVISION					
REV	DESCRIPTION	DRAWN	APPR	DATE	
1 R	Initial Registration			1998.05.25.	
1	특성 개선 (내부 형태 변경)	Y.H.SON	B.H.AN	2004.06.01.	
2	[설변201409-0008] 신뢰성 향상 (특성값 기준 변경)	E.H.KIM	I.C.KIM	2014.09.23.	

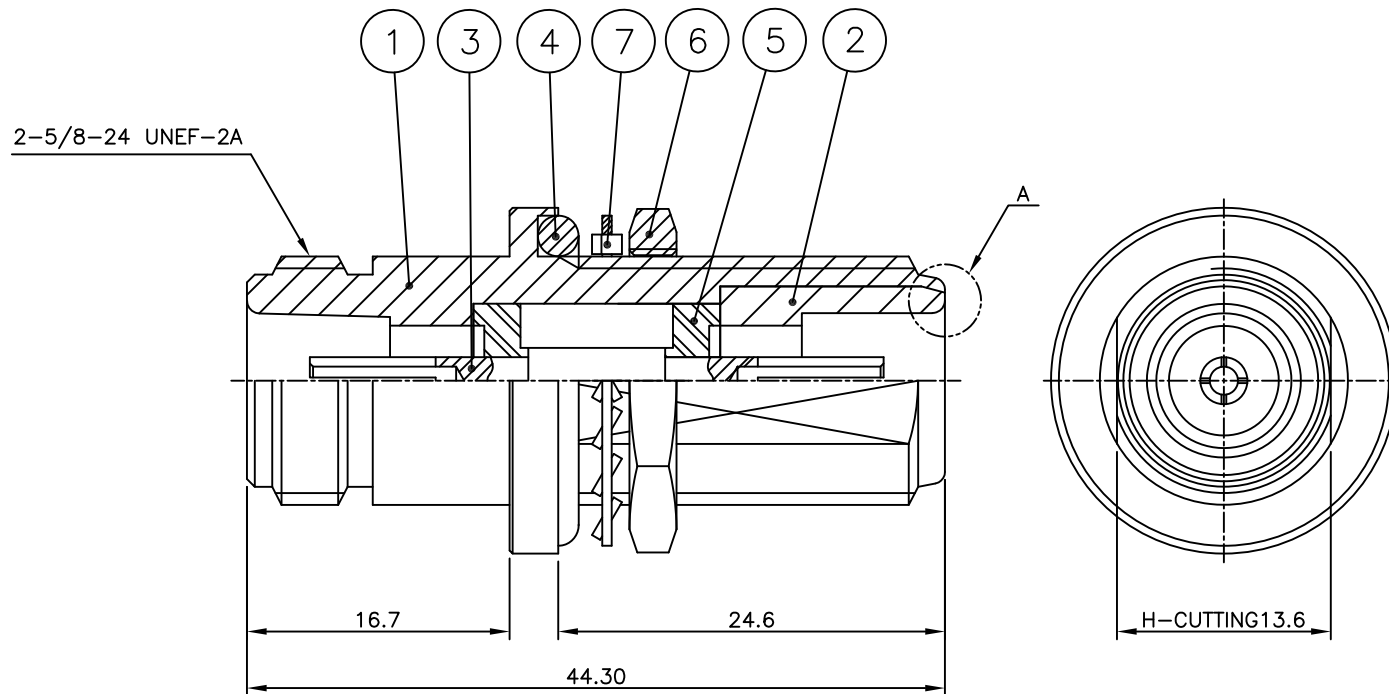

* 주 기
A부분 가시미 작업 할 것.

7	WASHER	1	BsS	SUCO Plated	DWA00051-5/1
6	NUT	1	MBsBD	SUCO Plated	DNT00035-5/1
5	INSULATOR	1	TEFLON		DIN00699-N/1
4	GASKET	1	NBR	BLACK	DGK00046-N/1
3	CONTACT	1	BeCu	Gold Plated	DCT00620-5/1
2	BODY	1	MBsBD	SUCO Plated	DBD00923-5/2
1	BODY	1	MBsBD	SUCO Plated	DBD00799-5/2
NO.	DESCRIPTION	Q'TY	MATERIAL	PLATING	CODE

* ELECTRICAL SPECIFICATIONS

Impedance : 50Ω Nominal

Frequency Range : DC~6GHz

△₂ V.S.W.R : ~~1.2 max~~ 1.25 max

△₂ Insertion Loss : ~~-0.12 min~~ -0.3dB min

TOLERANCE	Decimal	DATE			 RF & MICROWAVE TECHNOLOGY Tel : 82-32-347-8015 Fax : 82-32-347-8017	
	±0.2	2014. 09. 23.				
	Angle	APPROVED BY		I.C.KIM		
		CHECKED BY				
MATERIAL		DRAWN BY		TITLE		
-		E.H.KIM		N50 (J) N50 (J) BH ADAPTOR		
FINISH		SCALE	UNIT	 A4	DWG NO.	
-		2/1	mm		AD00102-7/2	
				REVISION	SHEET	
				2	1 of 1	