


| REVISION |                                 |         |         |             |
|----------|---------------------------------|---------|---------|-------------|
| REV      | DESCRIPTION                     | DRAWN   | APPR    | DATE        |
| IR       | Initial Registration            | H.J.LEE | I.C.KIM | 2014.12.26. |
| 1        | [설번No.201507-0010] 3번 커넥터 코드 변경 | H.J.LEE | I.C.KIM | 2015.07.10. |

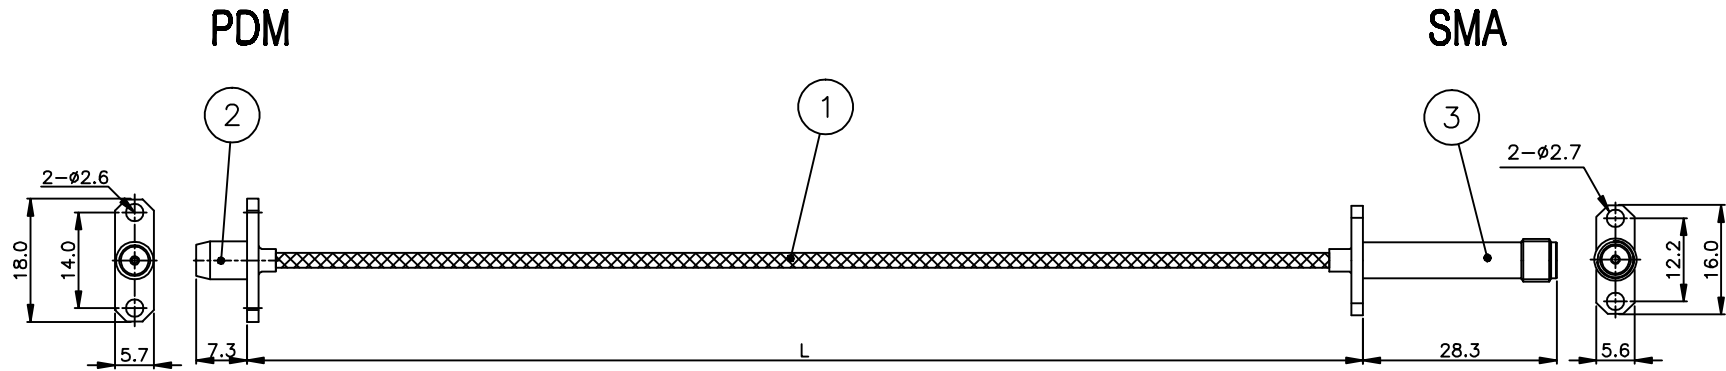

## Notes

1. RoHS & Pb-FREE
2. CONNECTOR FINISHES
  - 2.1 PDM(Ø5.5)-JS-2H → BODY : Nickel Plating  
CONTACT : Gold Plating
  - 2.2 SMA50-J-2H → BODY : Gold Plating  
CONTACT : Gold Plating

|                                                                                       |   |               |                                                                                       |                      |                                                                                                                                                                       |                 |
|---------------------------------------------------------------------------------------|---|---------------|---------------------------------------------------------------------------------------|----------------------|-----------------------------------------------------------------------------------------------------------------------------------------------------------------------|-----------------|
|  | 3 | CONNECTOR     | 1                                                                                     | KJ COMTECH           | <del>CN01042-7/3</del><br><del>CN01042-7/2</del>                                                                                                                      | SMA50-JS-2H     |
|                                                                                       | 2 | CONNECTOR     | 1                                                                                     | KJ COMTECH           | CN08179-7/3                                                                                                                                                           | PDM(Φ5.5)-JS-2H |
|                                                                                       | 1 | COAXIAL CABLE |                                                                                       | EXPANTEL             | ACA00027-N/1                                                                                                                                                          | 85F (1671A)     |
| NO.                                                                                   |   | DESCRIPTION   | Q'TY                                                                                  | VENDER               | PART NO.                                                                                                                                                              | RAMARKS         |
| DATE                                                                                  |   |               | 2015. 07. 10.                                                                         |                      | <br>RF & MICROWAVE<br>TECHNOLOGY<br>TEL : 02-92-947-0015<br>Fax : 02-92-947-0017 |                 |
| APPROVED BY                                                                           |   | I.C.KIM       |                                                                                       | TITLE<br>CABLE ASS'Y |                                                                                                                                                                       |                 |
| CHECKED BY                                                                            |   | S.M.LEE       |                                                                                       |                      |                                                                                                                                                                       |                 |
| DRAWN BY                                                                              |   | H.J.LEE       |                                                                                       |                      |                                                                                                                                                                       |                 |
| CHECKED BY                                                                            |   |               |                                                                                       |                      |                                                                                                                                                                       |                 |
| SCALE                                                                                 |   | UNIT          |  | A4                   | DWG NO.                                                                                                                                                               | CF00975-7/1     |
| N/S                                                                                   |   | mm            |                                                                                       |                      | DETAIL NO.                                                                                                                                                            |                 |
|                                                                                       |   |               |                                                                                       | REVISION             | 1                                                                                                                                                                     | SHEET 1 of 1    |



KJ COMTECH CO., LTD.

RF & MICROWAVE  
TECHNOLOGY  
TEL : 02-92-007-0015  
FAX : 02-92-007-0017