
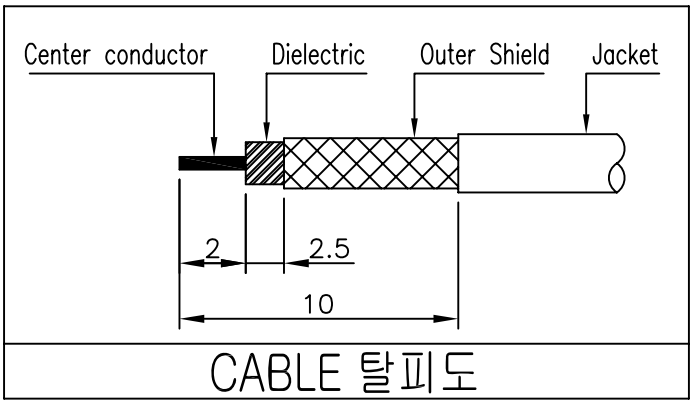
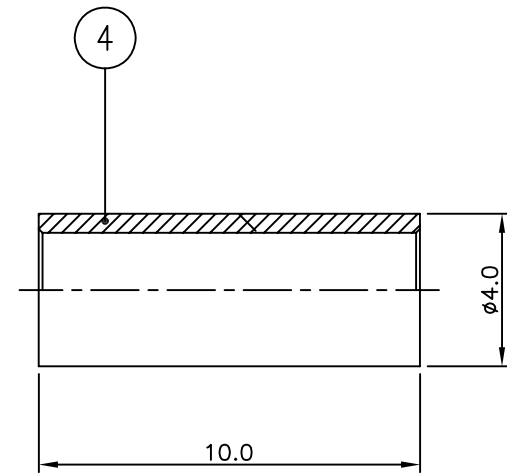


1 2 3 4 5 6

| REVISION |                                      |          |         |             |
|----------|--------------------------------------|----------|---------|-------------|
| REV      | DESCRIPTION                          | DRAWN    | APPR    | DATE        |
| IR       | Initial Registration                 | M.H.SONG | I.C.KIM | 2014.01.02. |
| 1        | [설변처리 No.201411-0022] 메이팅부 치수 표준화 적용 | I.C.KIM  | I.C.KIM | 2014.11.24. |

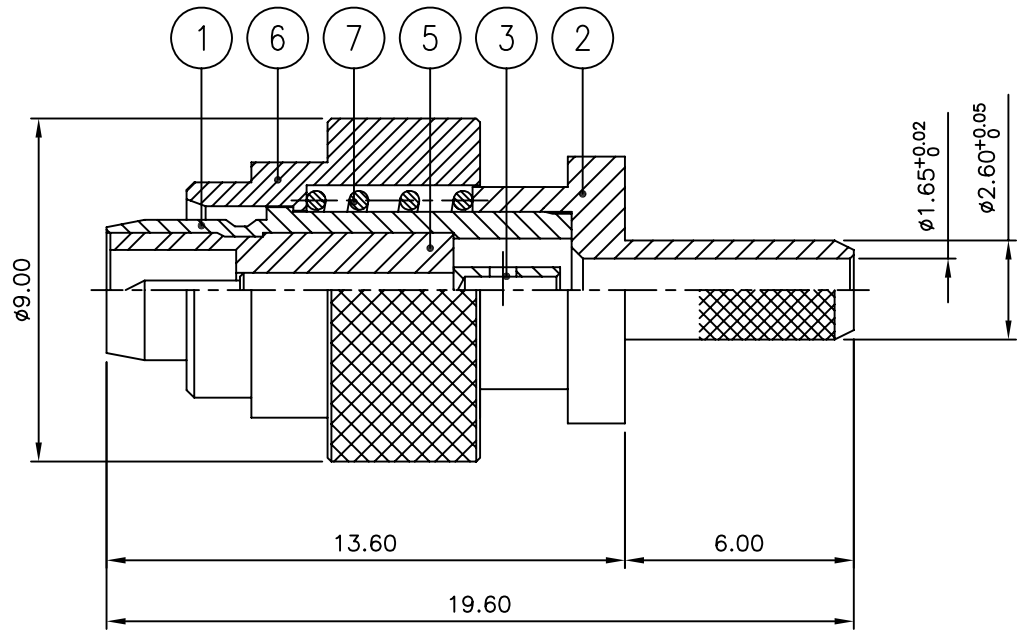

| 7   | SPRING      | 1    | SUS      | Passivate    | DSR01102-5/1                            |
|-----|-------------|------|----------|--------------|-----------------------------------------|
| 6   | CAP         | 1    | MBsBD    | Nickel Plate | DCU02233-5/2<br><del>DCU02233-5/1</del> |
| 5   | INSULATOR   | 1    | TEFLON   |              | DIN02021-N/1                            |
| 4   | FERRULE     | 1    | MBsBD    | Nickel Plate | DFE00034-5/1                            |
| 3   | CONTACT     | 1    | MBsBD    | Gold Plate   | DCT02613-5/1                            |
| 2   | BODY        | 1    | MBsBD    | Nickel Plate | DBD03203-5/1                            |
| 1   | BODY        | 1    | MBsBD    | Nickel Plate | DBD03088-5/5<br><del>DBD03088-5/3</del> |
| NO. | DESCRIPTION | Q'TY | MATERIAL | PLATING      | CODE                                    |

|           |         |                    |         |                                                                                       |                                                                                                                     |                                              |             |
|-----------|---------|--------------------|---------|---------------------------------------------------------------------------------------|---------------------------------------------------------------------------------------------------------------------|----------------------------------------------|-------------|
| TOLERANCE | Decimal | DATE 2017. 01. 06. |         |                                                                                       | <br><b>KJ COMTECH CO.,LTD.</b> | RF & MICROWAVE<br>TECHNOLOGY                 |             |
|           | Angle   | APPROVED BY        | I.C.KIM |                                                                                       |                                                                                                                     | Tel : 82-32-347-8015<br>Fax : 82-32-347-8017 |             |
| MATERIAL  | ±1°     | CHECKED BY         | I.C.KIM |                                                                                       | TITLE                                                                                                               | SMBL50 CABLE PS SIFS                         |             |
|           |         | DRAWN BY           | I.C.KIM |                                                                                       |                                                                                                                     |                                              |             |
| FINISH    |         | SCALE              | UNIT    |  | A4                                                                                                                  | DWG NO.                                      | CN02826-7/6 |
|           |         | 5/1                | mm      |                                                                                       |                                                                                                                     | REVISION                                     | 1           |

1 2 3 4 5 6