
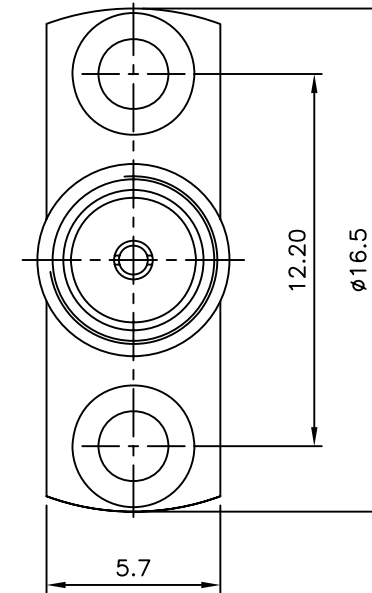


| REVISION |                                                |         |         |               |
|----------|------------------------------------------------|---------|---------|---------------|
| REV      | DESCRIPTION                                    | DRAWN   | APPR    | DATE          |
| IR       | Initial Registration                           | H.J.LEE | I.C.KIM | 2015. 01. 06. |
| 1        | [설번No.201602-0011] 업체 요청으로 인한 TEFLON,PIN 길이 변경 | H.J.LEE | I.C.KIM | 2016. 02. 17. |
| 2        | [설번No.201603-0002] PIN 길이 잘 못 기재하여 수정          | H.J.LEE | I.C.KIM | 2016. 03. 04. |

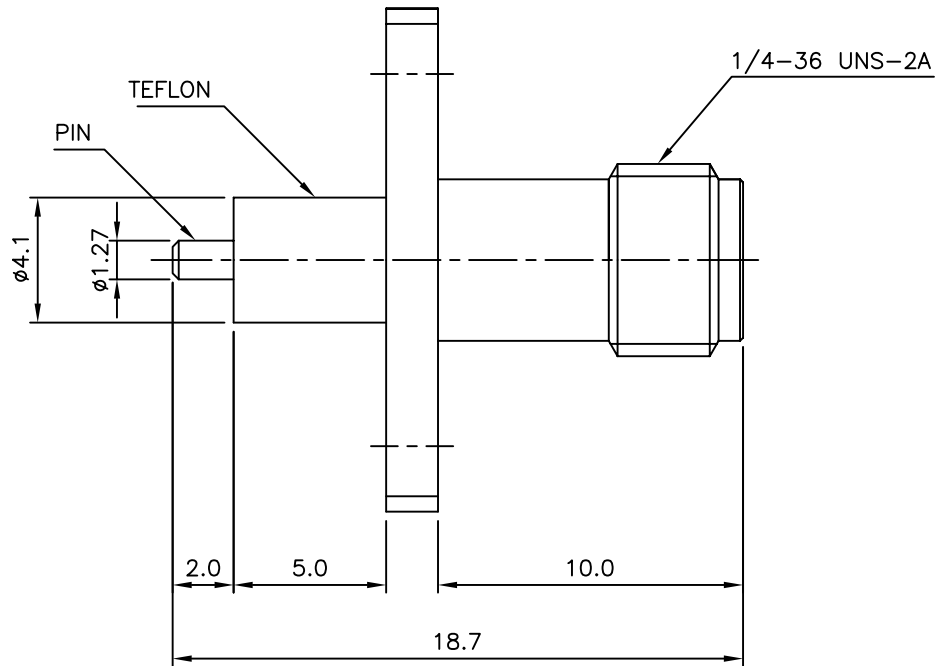

|   |     |             |      |                    |              |                                         |
|---|-----|-------------|------|--------------------|--------------|-----------------------------------------|
| 1 | 3   | INSULATOR   | 1    | TEFLON             |              | DIN02725-N/1<br><del>DIN02713-N/1</del> |
| 2 | 2   | CONTACT     | 1    | BeCu<br>C17300     | Gold Plate   | DCT03645-5/1<br><del>DCT03621-5/1</del> |
|   | 1   | BODY        | 1    | MBsBD<br>C3604BD-F | Nickel Plate | DBD04104-5/1                            |
|   | NO. | DESCRIPTION | Q'TY | MATERIAL           | PLATING      | CODE                                    |

|           |         |                    |         |                                                                               |
|-----------|---------|--------------------|---------|-------------------------------------------------------------------------------|
| TOLERANCE | Decimal | DATE 2016. 03. 04. |         | <br>RF & MICROWAVE TECHNOLOGY<br>Tel : 82-32-347-8015<br>Fax : 82-32-347-8017 |
|           | Angle   | APPROVED BY        | I.C.KIM |                                                                               |
| MATERIAL  |         | CHECKED BY         |         | <b>KJ COMTECH CO.,LTD.</b><br>TITLE<br>SMA50 SOLDER END JS-2H                 |
|           |         | DRAWN BY           | H.J.LEE |                                                                               |
| FINISH    |         | SCALE              | UNIT    | A4 DWG NO. CN03544-7/1<br>REVISION 2 SHEET 1 of 1                             |
|           |         | 4/1                | mm      |                                                                               |