REVISION					
No.	DESCRIPTION	REV	DRAWN	APPR	DATE
IR	Initial Registration	IR	H.J.LEE	I.C.KIM	2014. 12. 30.
1	[설변처리No.201612-001] 제작자료와 상이함으로 인한 부적합 개선	1	C.K.KIM	I.C.KIM	2016. 12. 20.

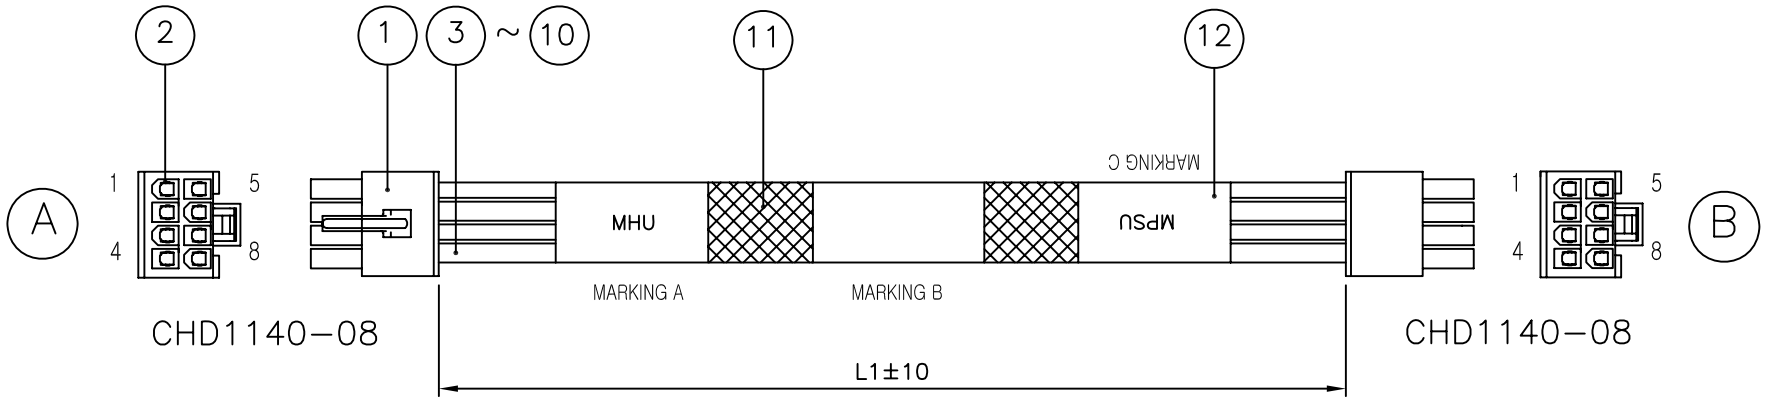

A			B
RED	1	1	RED
YELLOW	2	2	YELLOW
BLACK	3	3	BLACK
GREEN	4	4	GREEN
WHITE	5	5	WHITE
ORANGE	6	6	ORANGE
BROWN	7	7	BROWN
BLUE	8	8	BLUE

NO.	DESCRIPTION	Q'TY	VENDER	PART NO.	RAMARKS
12	MARKING TUBE	3	LS TUBE	ATU00225-N/1	⌀10.5-WHITE
11	EXPAND	1	1/4"	ATU00359-N/1	300mm(BLACK)
10	CABLE	1	0.75SQ	ACA00325-N/1	280mm(GREEN)
9	CABLE	1	0.75SQ	ACA00324-N/1	280mm(YELLOW)
8	CABLE	1	0.75SQ	ACA00323-N/1	280mm(ORANGE)
7	CABLE	1	0.75SQ	ACA00322-N/1	280mm(BRWON)
6	CABLE	1	0.75SQ	ACA00358-N/1	280mm(BLUE)
5	CABLE	1	0.75SQ	ACA00321-N/1	280mm(BLACK)
4	CABLE	1	0.75SQ	ACA00359-N/1	280mm(WHITE)
3	CABLE	1	0.75SQ	ACA00320-N/1	280mm(RED)
2	TERMINAL PIN	16	HANLIM ~~MOLEX~~	DCN00104-N/1 ~~DCN00184-N/1~~	CTD1140 ~~5557-08~~
1	HOUSING	2	HANLIM ~~MOLEX~~	DCN00278-N/1 ~~DCN00168-N/1~~	CHD1140-08 ~~5557-08~~

MHU		MPSU
MARKING A	MARKING B	MARKING C

(MARKING 방향 주의)

CUSTOMER

CUSTOMER CODE

CABLE LENGTH TOLERANCE
0 ~ 1000mm : +5, -0
1000 ~ 2000mm : +10, -0
2000 ~ 3000mm : +15, -0
3000 ~ 4000mm : +20, -0
4000 ~ 5000mm : +25, -0
5000 ~ : +10%

DATE	2016. 12. 20.
APPROVED BY	I.C.KIM
CHECKED BY	
DRAWN BY	C.K.KIM
CHECKED BY	
SCALE	N/S
UNIT	mm

KJ COMTECH
KJ COMTECH CO.,LTD.
RF & MICROWAVE TECHNOLOGY
Tel : 82-32-347-8015
Fax : 82-32-347-8017

TITLE
FAN Power & Signal

A4

DWG NO.	CD00121-7/1
DETAIL NO.	
REVISION	1
SHEET	1 of 1