REVISION

No.	DESCRIPTION	REV	DRAWN	APPR	DATE
IR	Initial Registration	IR	S.M.LEE	I.C.KIM	2015. 02. 09.
1	[설변처리No.201612-001] 제작자료와 상이함으로 인한 부적합 개선	1	C.K.KIM	I.C.KIM	2016. 12. 01.

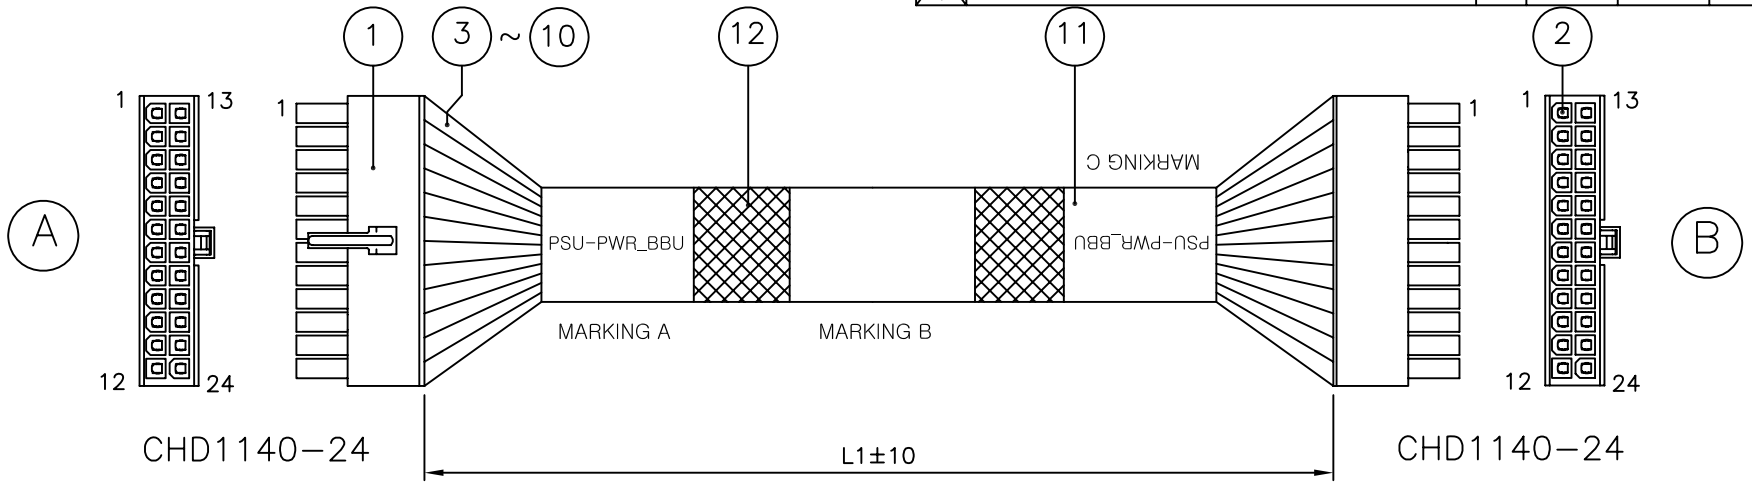

	12	EXPANDER	1	1/4"	ATU00359-N/1	230mm
	11	MARKING TUBE	3	LS TUBE	ATU00228-N/1	Ø12 White
1	10	CABLE	2	AWG#20 UL1333	ACA00273-N/1	230mm (GREEN)
1	9	CABLE	2	AWG#20 UL1333	ACA00270-N/1	230mm (RED)
1	8	CABLE	2	AWG#20 UL1333	ACA00275-N/1	230mm (BLUE)
1	7	CABLE	2	AWG#20 UL1333	ACA00276-N/1	230mm (WHITE)
1	6	CABLE	4	AWG#20 UL1333	ACA00272-N/1	230mm (YELLOW)
1	5	CABLE	4	AWG#20 UL1333	ACA00269-N/1	230mm (ORANGE)
1	4	CABLE	4	AWG#20 UL1333	ACA00271-N/1	230mm (BROWN)
1	3	CABLE	4	AWG#20 UL1333 ~~TEFLON WIRE~~	ACA00274-N/1 ~~ACA00379-N/1~~	230mm (BLACK) ~~0.5SQ (BLACK)~~
1	2	TERMINAL PIN	48	HANLIM ~~MOLEX~~	DCN00104-N/1 ~~DCN00115-N/1~~	CTD1140 ~~5556T~~
1	1	HOUSING	2	HANLIM ~~MOLEX~~	DCN00273-N/1 ~~DCN00178-N/1~~	CHD1140-24 ~~5557-24~~
	NO.	DESCRIPTION	Q'TY	VENDER	PART NO.	RAMARKS

PSU-PWR_BBU

MARKING A

MARKING B

PSU-PWR_BBU

MARKING C
(마킹 방향 주의)

A			B
BLACK	1	1	BLACK
BROWN	2	2	BROWN
ORANGE	3	3	ORANGE
YELLOW	4	4	YELLOW
RED	5	5	RED
WHITE	6	6	WHITE
BLUE	7	7	BLUE
GREEN	8	8	GREEN
BLACK	9	9	BLACK
BROWN	10	10	BROWN
ORANGE	11	11	ORANGE
YELLOW	12	12	YELLOW

A			B
BLACK	13	13	BLACK
BROWN	14	14	BROWN
ORANGE	15	15	ORANGE
YELLOW	16	16	YELLOW
RED	17	17	RED
WHITE	18	18	WHITE
BLUE	19	19	BLUE
GREEN	20	20	GREEN
BLACK	21	21	BLACK
BROWN	22	22	BROWN
ORANGE	23	23	ORANGE
YELLOW	24	24	YELLOW

CUSTOMER

CUSTOMER CODE

CABLE LENGTH TOLERANCE
0 ~ 1000mm : +5, -0
1000 ~ 2000mm : +10, -0
2000 ~ 3000mm : +15, -0
3000 ~ 4000mm : +20, -0
4000 ~ 5000mm : +25, -0
5000 ~ : +10%

DATE	2016. 12. 01.
APPROVED BY	I.C.KIM
CHECKED BY	
DRAWN BY	C.K.KIM
CHECKED BY	
SCALE	N/S
UNIT	mm

KJ COMTECH
KJ COMTECH CO.,LTD.
RF & MICROWAVE TECHNOLOGY
Tel : 82-32-347-8015
Fax : 82-32-347-8017

TITLE
PSU-PWR_BBU POWER CABLE

A4

DWG NO.	CD00124-7/1
DETAIL NO.	
REVISION	1
SHEET	1 of 1