REVISION					
No.	DESCRIPTION	REV	DRAWN	APPR	DATE
IR	Initial Registration	IR	S.M.LEE	I.C.KIM	2015. 02. 09.
1	[설변처리No.201612-001] 제작자료와 상이함으로 인한 부적합 개선	1	C.K.KIM	I.C.KIM	2016. 12. 01.

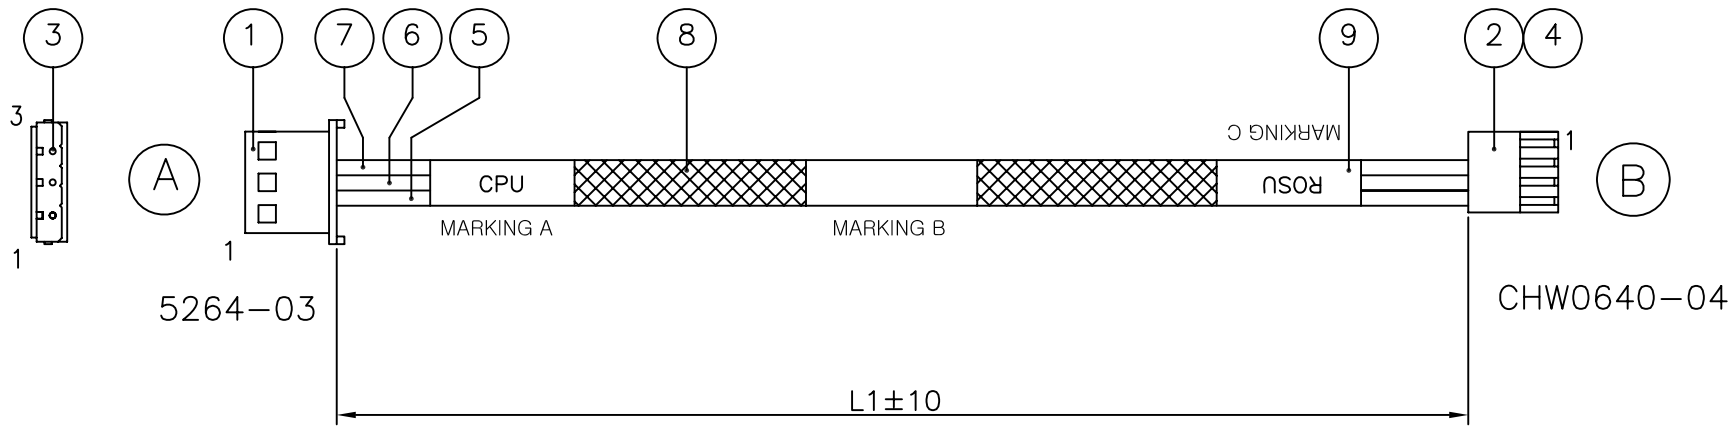

9	MARKER TUBE	3	LS TUBE	ATU00216-N/1	⌀6 WHITE
8	EXPAND	1	1/4"	ATU00359-N/1	270mm
7	CABLE	1	AWG#26 UL1007	ACA00257-N/1	270mm(BLACK)
6	CABLE	1	AWG#26 UL1007	ACA00261-N/1	270mm(BROWN)
5	CABLE	1	AWG#26 UL1007	ACA00253-N/1	270mm(RED)
4	TERMINLA PIN	3	HANLIM	DCN00161-N/1	CT0640 ~~CHW0640 Terminal Pin~~
3	TERMINLA PIN	3	MOLEX	DCN00149-N/1	5263PBT ~~5264 Terminal Pin~~
2	HOUSING	1	HANLIM	DCN00157-N/1	CHW0640-04
1	HOUSING	1	MOLEX	DCN00064-N/1	5264-03
NO.	DESCRIPTION	Q'TY	SPEC	PART NO.	RAMARKS

CPU		ROSU
MARKING A	MARKING B	MARKING C (마킹 방향 주의)

A

RED	1
BROWN	2
BLACK	3

1	N.C
2	BLACK
3	BROWN
4	RED

B

CUSTOMER

CUSTOMER CODE

CABLE LENGTH TOLERANCE
0 ~ 1000mm : +5, -0
1000 ~ 2000mm : +10, -0
2000 ~ 3000mm : +15, -0
3000 ~ 4000mm : +20, -0
4000 ~ 5000mm : +25, -0
5000 ~ : +10%

DATE	2016. 12. 01.
APPROVED BY	I.C.KIM
CHECKED BY	
DRAWN BY	C.K.KIM
CHECKED BY	
SCALE N/S	UNIT mm

KJ COMTECH
KJ COMTECH CO.,LTD.
RF & MICROWAVE TECHNOLOGY
Tel : 82-32-347-8015
Fax : 82-32-347-8017

TITLE
ROSU CABLE

A4

DWG NO.	CD00130-7/1
DETAIL NO.	
REVISION 1	SHEET 1 of 1