REVISION					
No.	DESCRIPTION	REV	DRAWN	APPR	DATE
IR	Initial Registration	IR	C.K.KIM	I.C.KIM	2016. 08. 17.
1	[설변처리No.201612-001]제작자료와 상이함으로 인한 부적합 개선	1	C.K.KIM	I.C.KIM	2016. 12. 01.

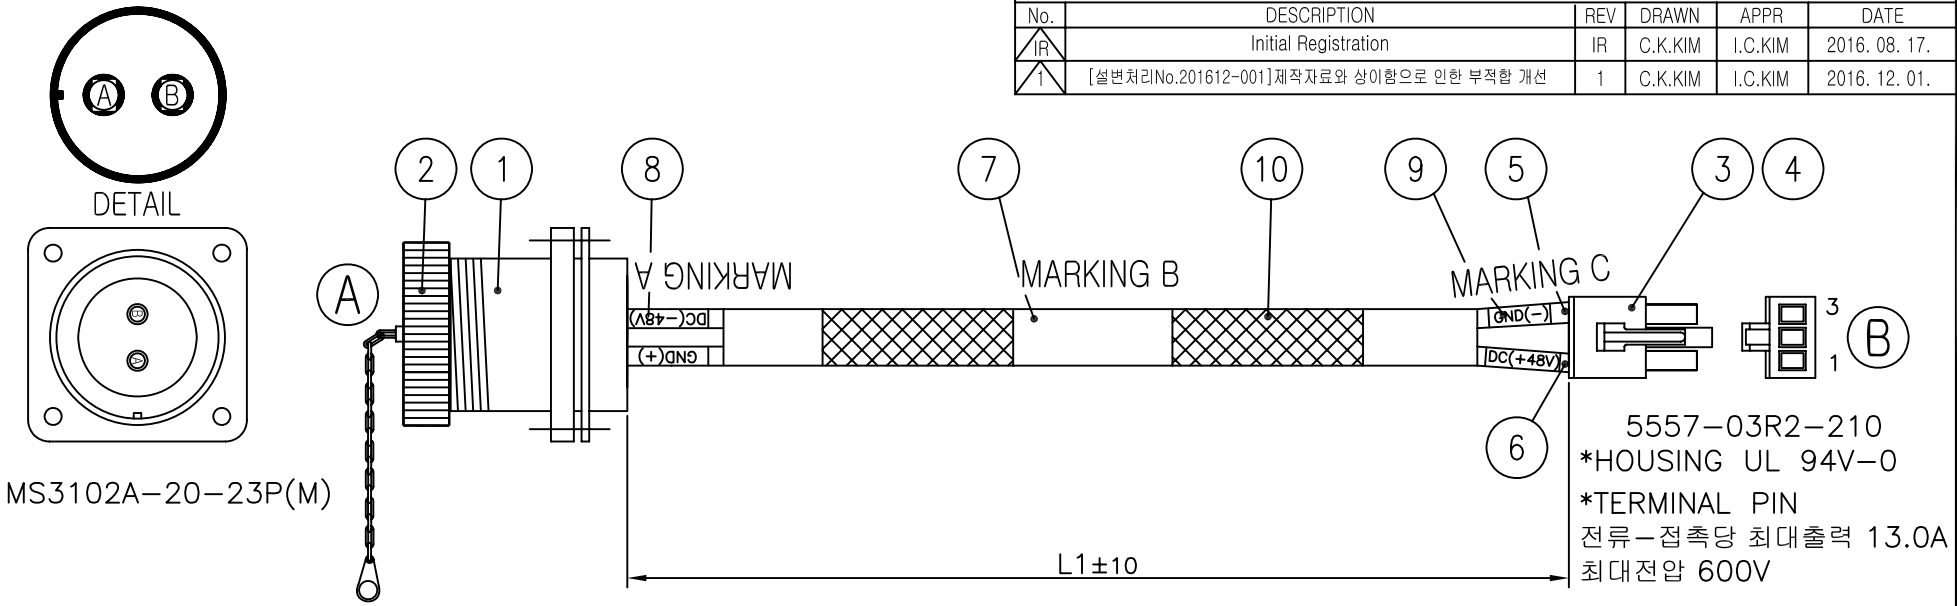

DC(-48V)
GND(+)

MARKING A DETAIL

MARKING B DETAIL

GND(-)
DC(+48V)

MARKING C DETAIL

*MARKING 방향 주의할 것

MS3102A-20-23P(M) 5557-03R2-210

A		
DC(-48V)	B	
GND(+)	A	

			B
3	BLUE	GND(-)	
2	N.C		
1	RED	DC(+48V)	

NO.	DESCRIPTION	Q'TY	VENDER	PART NO.	RAMARKS
10	GT TUBE	1		ATU00370-N/1	⌀8-300mm BLACK
9	MARKING TUBE	2	LS TUBE	ATU00216-N/1	⌀6-15mm WHITE
8	MARKING TUBE	2	LS TUBE	ATU00220-N/1	⌀8-15mm WHITE
7	MARKING & SHRINK TUBE	3	LS TUBE	ATU00224-N/1	⌀10-35mm WHITE
6	WIRE	1	AWG#20	ACA00439-N/1	UL1015 (RED) (345mm)
5	WIRE	1	AWG#20	ACA00438-N/1	UL1015 (BLUE) (345mm)
1 4	TERMINAL PIN	2	MOLEX	DCN00280-N/1 ~~DCN00248-N/1~~	45750-1111 ~~5557-03~~
1 3	HOUSING	1	MOLEX	DCN00191-N/1	5557-03R2-210 ~~5557-03~~
2	DUST CAP	1	YONGJIN	DCN00111-N/1	MS25043-20D
1	CONNECTOR	1	YONGJIN	DCN00252-N/1	MS3102A-20-23P(M)

CUSTOMER

CUSTOMER CODE

CABLE LENGTH TOLERANCE
0 ~ 1000mm : +5, -0
1000 ~ 2000mm : +10, -0
2000 ~ 3000mm : +15, -0
3000 ~ 4000mm : +20, -0
4000 ~ 5000mm : +25, -0
5000 ~ : +10%

DATE	2016. 12. 01.
APPROVED BY	I.C.KIM
CHECKED BY	
DRAWN BY	C.K.KIM
CHECKED BY	
SCALE	N/S
UNIT	mm

KJ COMTECH
KJ COMTECH CO.,LTD.
RF & MICROWAVE TECHNOLOGY
Tel : 82-32-347-8015
Fax : 82-32-347-8017

TITLE DC_CABLE_(INSIDE)

A4

DWG NO.	CD00151-7/1
DETAIL NO.	
REVISION 1	SHEET 1 of 1