REVISION					
No.	DESCRIPTION	REV	DRAWN	APPR	DATE
IR	Initial Registration	IR	C.K.KIM	I.C.KIM	2016. 08. 17.
1	[설변처리No.201612-001]제작자료와 상이함으로 인한 부적합 개선	1	C.K.KIM	I.C.KIM	2016. 12. 01.

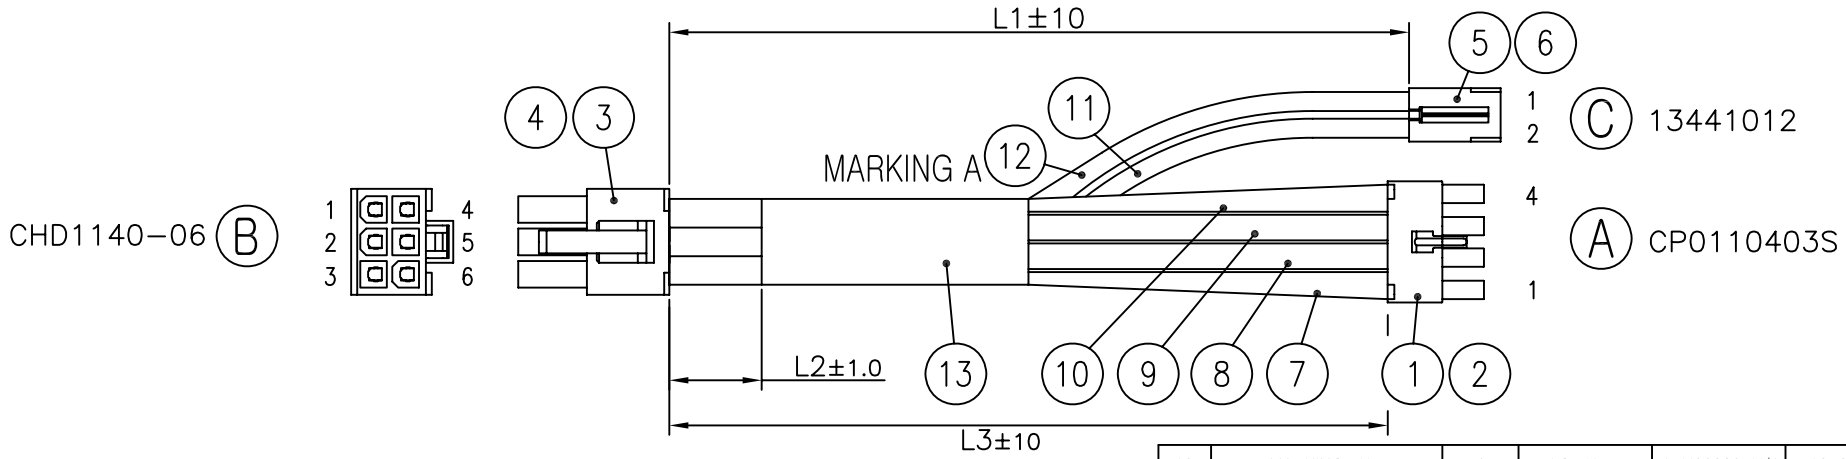

	NO.	DESCRIPTION	Q'TY	VENDER	PART NO.	RAMARKS
	13	MARKING TUBE	1	LS TUBE	ATU00230-N/1	⌀13-35mm WHITE
	12	WIRE	1	AWG#20	ACA00439-N/1	UL1015 (RED) (105mm)
	11	WIRE	1	AWG#20	ACA00441-N/1	UL1015 (ORANGE) (105mm)
	10	WIRE	1	AWG#20	ACA00440-N/1	UL1015 (YELLOW) (90mm)
	9	WIRE	1	AWG#20	ACA00435-N/1	UL1015 (WHITE) (90mm)
	8	WIRE	1	AWG#20	ACA00438-N/1	UL1015 (BLUE) (90mm)
	7	WIRE	1	AWG#20	ACA00436-N/1	UL1015 (BLACK) (90mm)
1	6	TERMINAL PIN	2	SHINNING ~~한림전자~~	DCN00276-N/1 ~~DCN00254-N/1~~	13443001(사급품) ~~CHS1143-02~~
1	5	HOUSING	1	SHINNING ~~한림전자~~	DCN00276-N/1 ~~DCN00253-N/1~~	13441012(사급품) ~~CHS1143-02~~
1	4	TERMINAL PIN	6	HANLIM	DCN00104-N/1	CTD1140 ~~1140~~
	3	HOUSING	1	HANLIM	DCN00150-N/1	CHD1140-06
1	2	TERMINAL PIN	4	CVILUX ~~MOLEX~~	DCN00277-N/1 ~~DCN00196-N/1~~	1100106(사급품) ~~5557-04~~
1	1	HOUSING	1	CVILUX ~~MOLEX~~	DCN00275-N/1 ~~DCN00248-N/1~~	CP0110403S(사급품) ~~5557-04R~~

CHD1140-06 (B)

RED	1
WHITE	2
YELLOW	3
ORANGE	4
BLACK	5
BLUE	6

13441012 (C)

1	RED
2	ORANGE

CP0110403S (A)

1	BLACK
2	BLUE
3	WHITE
4	YELLOW

MARKING A DETAIL

*MARKING 위치 주의 할 것.

CUSTOMER

CUSTOMER CODE

CABLE LENGTH TOLERANCE
0 ~ 1000mm : +5, -0
1000 ~ 2000mm : +10, -0
2000 ~ 3000mm : +15, -0
3000 ~ 4000mm : +20, -0
4000 ~ 5000mm : +25, -0
5000 ~ : +10%

DATE	2016. 12. 01.
APPROVED BY	I.C.KIM
CHECKED BY	
DRAWN BY	C.K.KIM
CHECKED BY	
SCALE	N/S
UNIT	mm

KJ COMTECH
KJ COMTECH CO.,LTD.
RF & MICROWAVE TECHNOLOGY
Tel : 82-32-347-8015
Fax : 82-32-347-8017

TITLE PSU_OUT_CABLE

A4

DWG NO.	CD00188-7/1
DETAIL NO.	
REVISION	1
SHEET	1 of 1