WORK / ST										
ST(Old)										
ST(Rev)										

REVISION

REV	DESCRIPTION	DATE
IR	초도개정	2008. 09. 04.
1	BOM 구성 통일로 인한 커넥터 코드 변경	2018. 04. 02.

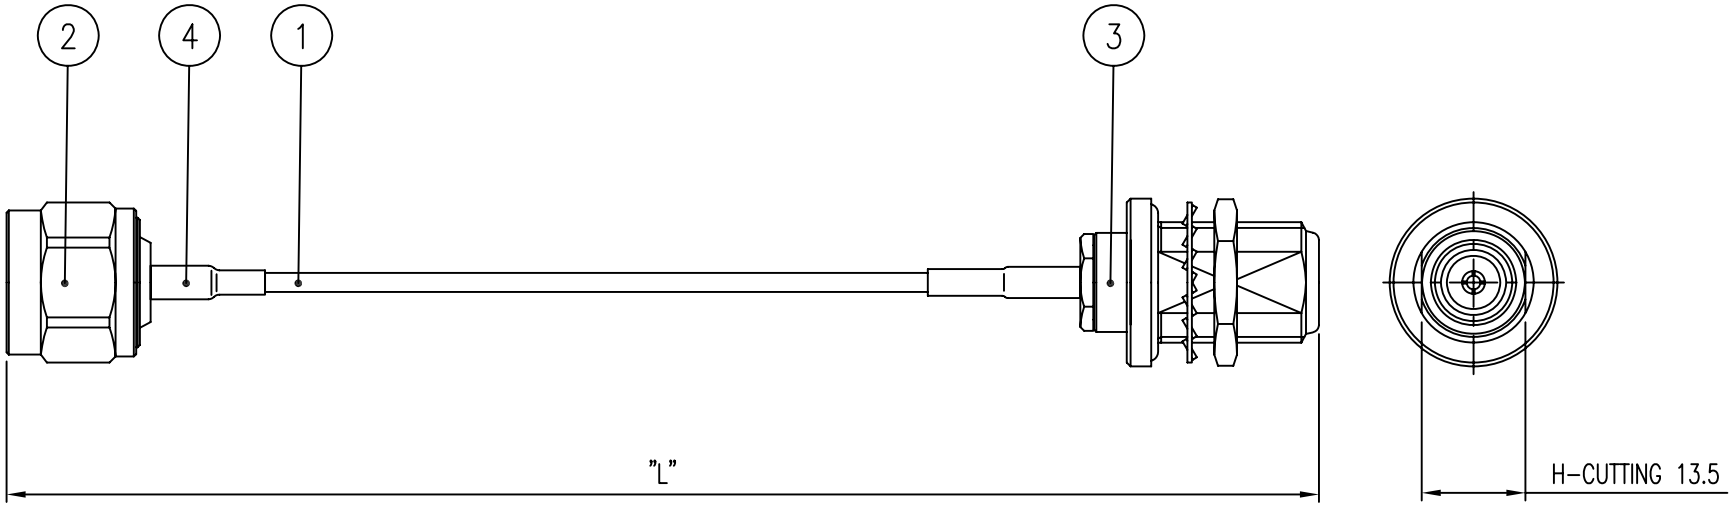

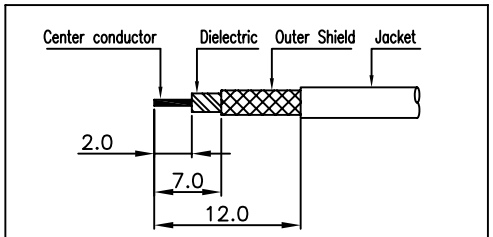

② 번 CABLE 탈피도

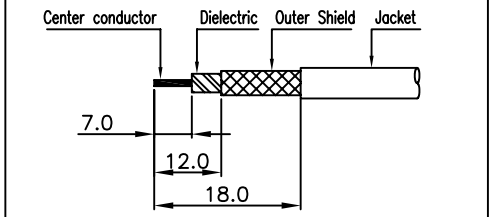

③ 번 CABLE 탈피도

Notes

1. RoHS & Pb-FREE
2. CONNECTOR FINISHES
   - 2-1. N50 PS---▶▷ BODY : Nickel Plating
     CONTACT : Gold Plating
     CAP : Nickel Plating
   - 2-2. N50-JB---▶▷ BODY : Nickel Plating
     CONTACT : Gold Plating
     NUT : Nickel Plating
     WASHER : Nickel Plating

	NO.	DESCRIPTION	Q'TY	VENDER	PART NO.	REMARKS
	4	SHRINK TUBE	2	LS TUBE	ATU00056-N/1	ϕ4x20 Black
1	3	CONNECTOR	1	KJ COMTECH	CN02034-7/1 ~~CN01855-7/1~~	N(F)-BH
1	2	CONNECTOR	1	KJ COMTECH	CN02804-7/1 ~~CN00419-7/2~~	N(M)-ST
1	1	COAXIAL CABLE		EXPANTEL	ACA00050-N/1 ~~CC00020-N/1~~	RG316DS(50Ω) (BROWN)

CUSTOMER	DATE	2018. 04. 02.	KJ COMTECH CO.,LTD. — RF & MICROWAVE TECHNOLOGY Tel : 82-32-347-8015 Fax : 82-32-347-8017
	APPROVED BY	I. C. KIM	
CUSTOMER CODE	CHECKED BY		TITLE: CABLE ASS'Y
CABLE LENGTH TOLERANCE	DRAWN BY	S. Y. EUN	
0 ~ 1000 : +5, -0 1000 ~ 2000 : +10, -0 2000 ~ 3000 : +15, -0 3000 ~ 4000 : +20, -0 4000 ~ 5000 : +25, -0 5000 ~ : +10%	SCALE: N/S — UNIT: mm — WEIGHT: —	A4	DWG NO. CF00393-7/1
			DETAIL CODE.