| REVISION | | |
|---|---|---|
| REV | DESCRIPTION | DATE |
| IR | Initial Registration | 2010. 02. 19. |
| 1 | [설변No.202201-0009] PIPE 압착 후 BURR 발생 개선으로 인한 PIPE 변경 | 2022. 01. 18. |

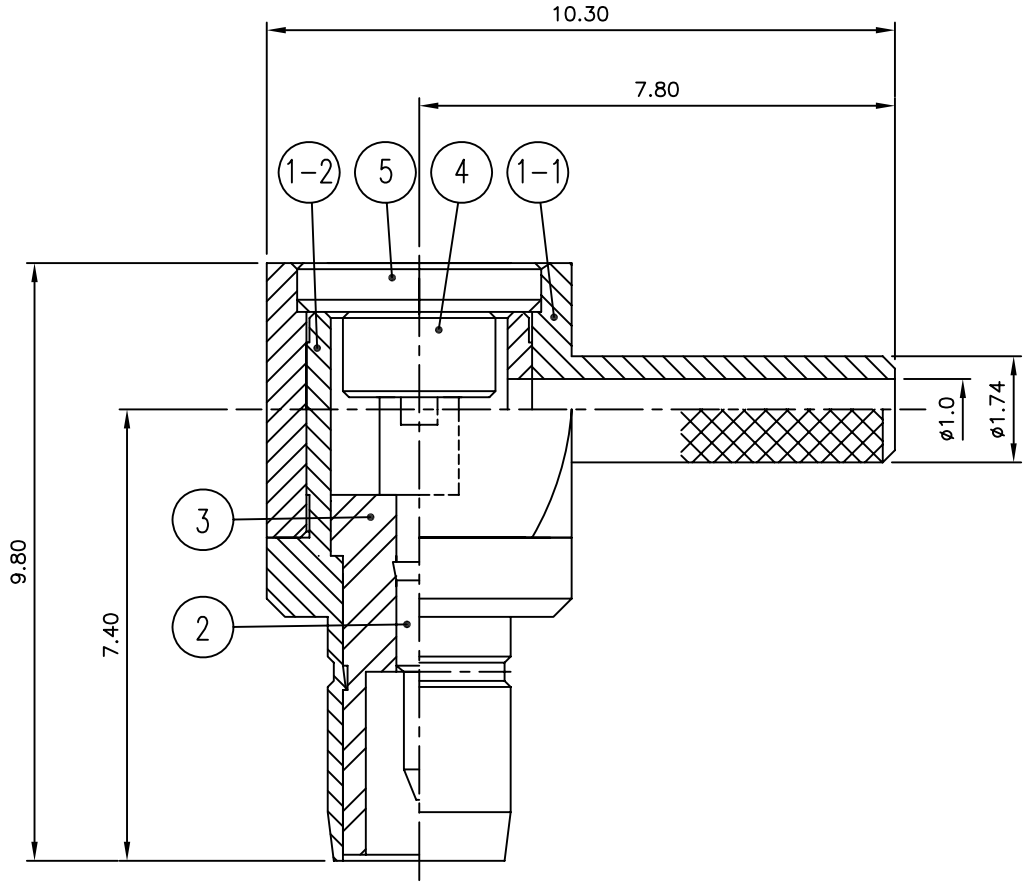


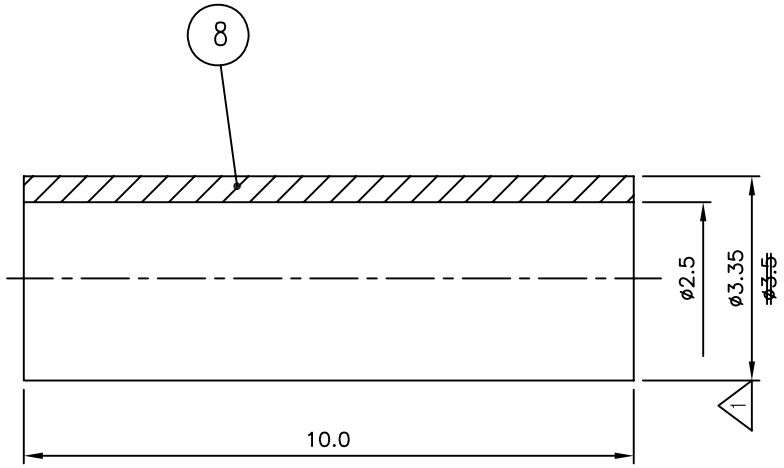


| | NO. | DESCRIPTION | Q'TY | MATERIAL | PLATING | CODE |
|---|---|---|---|---|---|---|
| 1 | 6 | FERRULE | 1 | MBsBD | Nickel Plate ~~Gold Plate~~ | DFE00018-5/2 ~~DFE00010-5/1 (F2001)~~ |
| | 5 | COVER | 1 | MBsBD | Gold Plate | DCO00014-5/1 (LS001) |
| | 4 | INSULATOR | 1 | TEFLON | | DIN00939-N/1 (HT012) |
| | 3 | INSULATOR | 1 | TEFLON | | DIN00370-N/1 (HT011) |
| | 2 | CONTACT | 1 | MBsBD | Gold Plate | DCT02217-5/1 |
| | 1-2 | BODY(B) | 1 | MBsBD | Gold Plate | DBB00262-5/1 DBD00529-3/1 (DT008B) |
| | 1-1 | BODY(A) | 1 | MBsBD | Gold Plate | DBB00262-5/1 DBD02707-3/1 |

| | | | |
|---|---|---|---|
| TOLERANCE | Decimal ±0.1 | DATE | 2022. 01. 18. |
| | Angle ±1° | APPROVED BY | S.H.KIM |
| | | CHECKED BY | |
| MATERIAL | ——— | DRAWN BY | S.Y.EUN |
| FINISH | ——— | SCALE 8/1 | UNIT mm |


KJ COMTECH
KJ COMTECH CO.,LTD.
RF & MICROWAVE TECHNOLOGY
Tel : 82-32-347-8015
Fax : 82-32-347-8017


TITLE: SMF50-PL-RG178

A4 | DWG NO. CN02545-7/1 | REVISION 1 | SHEET 1 of 1