| REVISION | | | | | |
|---|---|---|---|---|---|
| No. | DESCRIPTION | REV | DRAWN | APPR | DATE |
| IR | Initial Registration | IR | C.K.KIM | I.C.KIM | 2016. 08. 17. |
| 1 | [설변처리No.201612-001] 제작자료와 상이함으로 인한 부적합 개선 | 1 | C.K.KIM | I.C.KIM | 2016. 12. 01. |

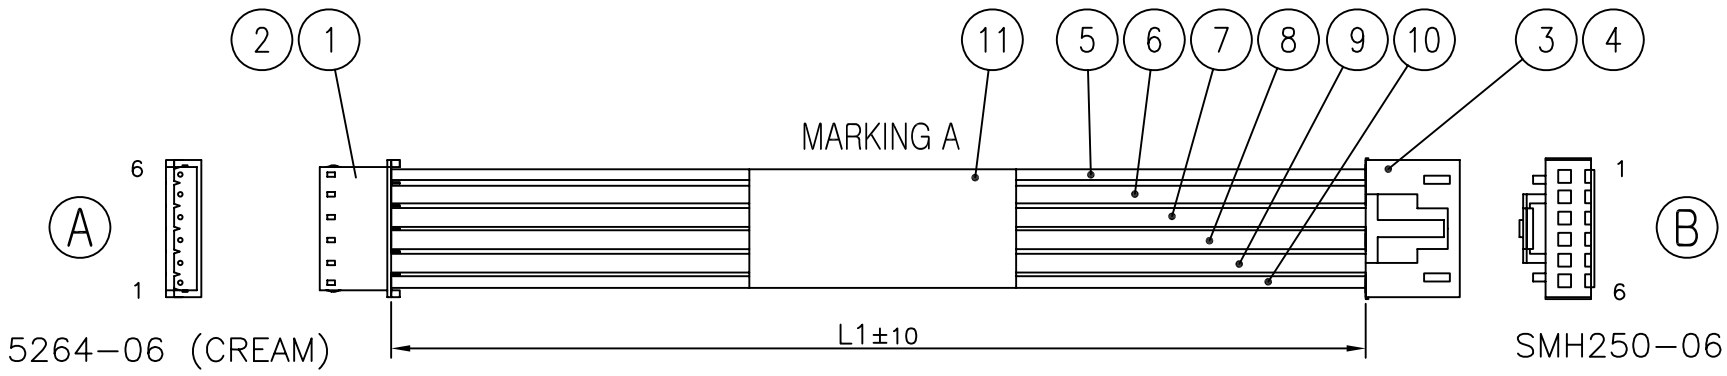


5264-06 (CREAM) SMH250-06

| A | | | B | |
|---|---|---|---|---|
| BLACK | 1 | ↔ | 1 | BLACK |
| BRWON | 2 | ↔ | 2 | BRWON |
| RED | 3 | ↔ | 3 | RED |
| ORANGE | 4 | ↔ | 4 | ORANGE |
| YELLOW | 5 | ↔ | 5 | YELLOW |
| GREEN | 6 | ↔ | 6 | GREEN |

| NO. | DESCRIPTION | Q'TY | VENDER | PART NO. | RAMARKS |
|---|---|---|---|---|---|
| 11 | MARKING TUBE | 1 | LS TUBE | ATU00224-N/1 | ⌀10-35mm WHITE |
| 10 | WIRE | 1 | AWG#24 | ACA00295-N/1 | UL1007 (GREEN) (138mm) |
| 9 | WIRE | 1 | AWG#24 | ACA00326-N/1 | UL1007 (YELLOW) (138mm) |
| 8 | WIRE | 1 | AWG#24 | ACA00297-N/1 | UL1007 (ORANGE) (138mm) |
| 7 | WIRE | 1 | AWG#24 | ACA00247-N/1 | UL1007 (RED) (138mm) |
| 6 | WIRE | 1 | AWG#24 | ACA00305-N/1 | UL1007 (BRWON) (138mm) |
| 5 | WIRE | 1 | AWG#24 | ACA00248-N/1 | UL1007 (BLACK) (138mm) |
| 1 4 | TERMINAL PIN | 6 | YEONHO | DCN00078-N/1 | YST025 ~~SMH250 Terminal PIN~~ |
| 3 | CONNECTOR | 1 | YEONHO | DCN00098-N/1 | SMH250-06 |
| 1 2 | TERMINAL PIN | 6 | MOLEX ~~한림전자~~ | DCN00149-N/1 ~~DCN00250-N/1~~ | 5263PBT ~~CHB0640-06 Terminal PIN~~ |
| 1 1 | HOUSING | 1 | MOLEX ~~한림전자~~ | DCN00037-N/1 ~~DCN00249-N/1~~ | 5264-06 (CREAM) ~~CHB0640-06~~ |

MARKING A DETAIL

CUSTOMER

CUSTOMER CODE

CABLE LENGTH TOLERANCE
0 ~ 1000mm : +5, -0
1000 ~ 2000mm : +10, -0
2000 ~ 3000mm : +15, -0
3000 ~ 4000mm : +20, -0
4000 ~ 5000mm : +25, -0
5000 ~ : +10%

| | |
|---|---|
| DATE | 2016. 12. 01. |
| APPROVED BY | I.C.KIM |
| CHECKED BY | |
| DRAWN BY | C.K.KIM |
| CHECKED BY | |
| SCALE | N/S |
| UNIT | mm |


KJ COMTECH
KJ COMTECH CO.,LTD.
RF & MICROWAVE TECHNOLOGY
Tel : 82-32-347-8015
Fax : 82-32-347-8017


TITLE PSU_ALARM

A4

| | |
|---|---|
| DWG NO. | CD00152-7/1 |
| DETAIL NO. | |
| REVISION | 1 |
| SHEET | 1 of 1 |